





- Point of Connection to Existing
- Sidewall Sprinkler Head
- Pendant Sprinkler Head
- Upright Sprinkler Head

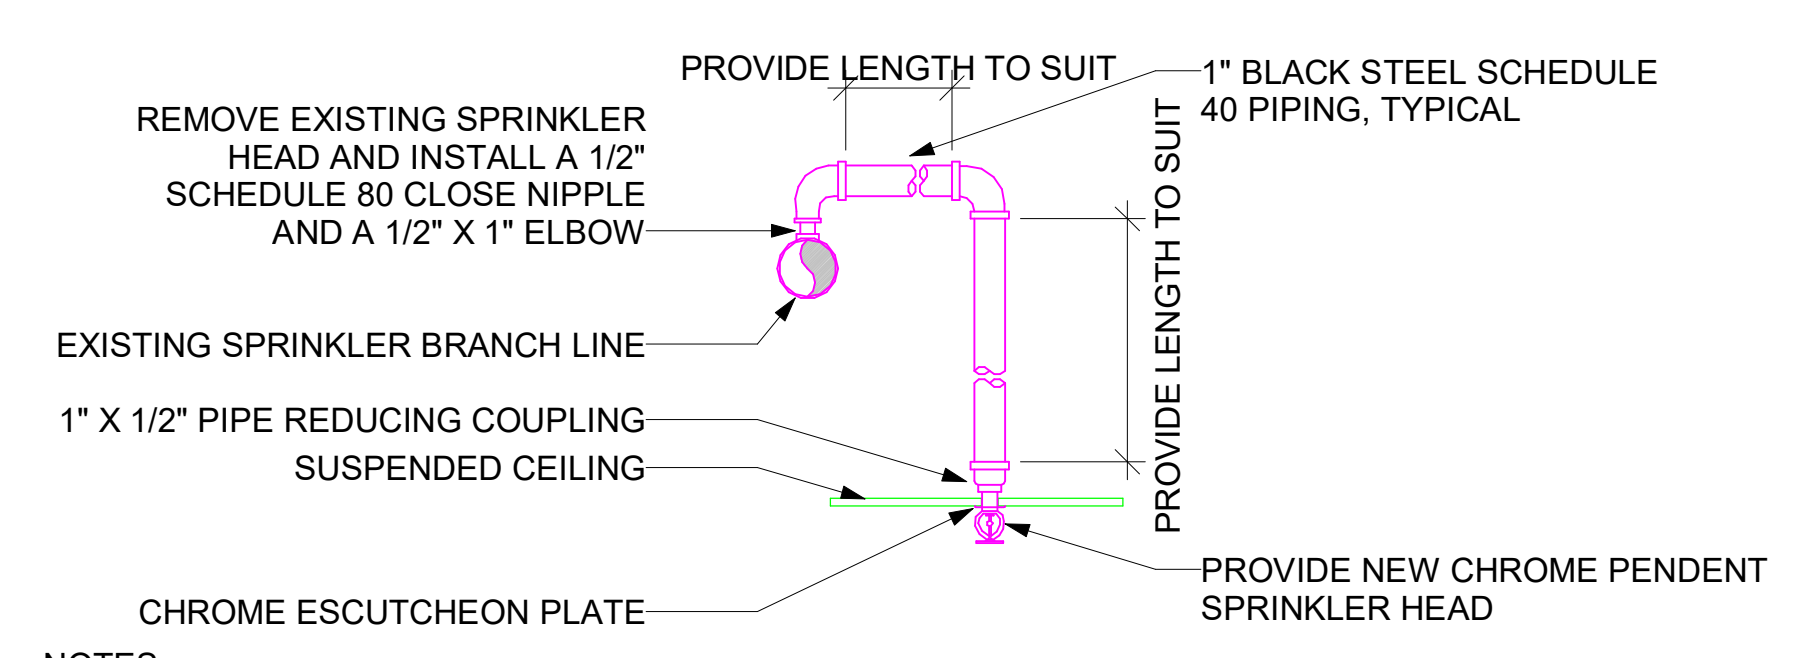

- NOTES:**
- ADJUST SPRINKLER DROPS AS NECESSARY TO CLEAR OBSTRUCTIONS SUCH AS THE CEILING "T" BAR SUSPENSION SYSTEM, LIGHT FIXTURES, ETC. PROVIDE A PIPE HANGER IF THE HORIZONTAL OFFSET LENGTH EXCEEDS 24 INCHES.
  - THIS SPRINKLER HEAD DROP IS APPLICABLE ONLY WHERE IT IS NOT NECESSARY TO RETAIN AN UPRIGHT SPRINKLER HEAD FOR PROTECTION OF COMBUSTIBLE CONSTRUCTION ABOVE THE CEILING.

TYPICAL NEW SPRINKLER HEAD DROP DETAIL  
N.T.S.

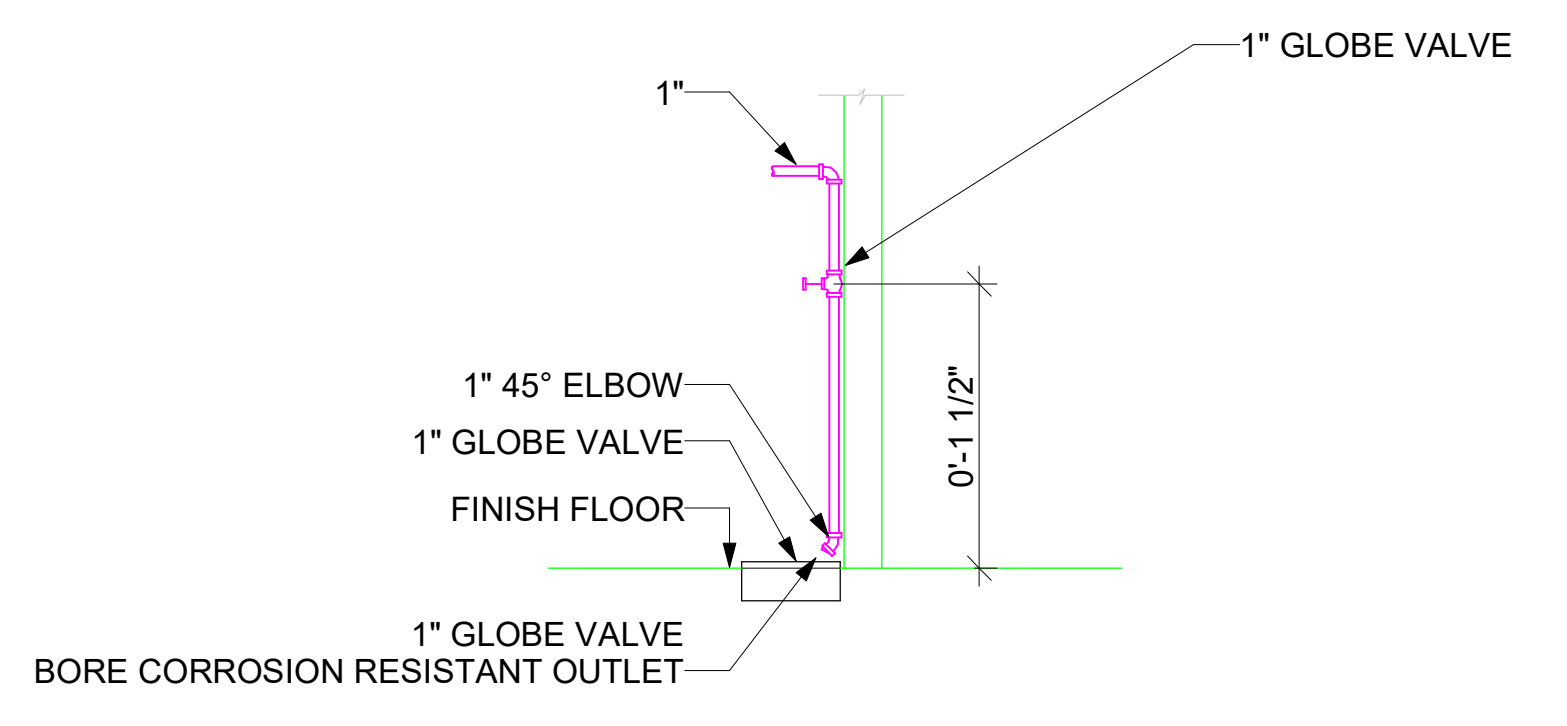

INSPECTOR'S TEST CONNECTION FOR WET PIPE SPRINKLER SYSTEM DETAIL  
N.T.S.

FIRE PROTECTION SECOND LEVEL AREA A  
3/8" = 1'-0"

AS-BUILT

REVISION	DESCRIPTION	DATE	APPROVED

New York City Transit Authority  
 DEPARTMENT OF CAPITAL PROGRAM MANAGEMENT

**CONTRACT: C-40218**  
 MEZZANINE BUS EXTENSION AT ULMER PARK BUS DEPOT

**FIRE PROTECTION SECOND LEVEL AREA A**

50-01 26TH AVE SUITE 110  
 WOODSIDE, NY 11377  
 TEL: (718) 204-1901 FAX: (718) 204-1902

CAD/CADD: [Name] DATE: [Date] DRAWN BY: [Name] DATE: [Date]  
 CHECKED BY: [Name] DATE: [Date] APPROVED BY: [Name] DATE: [Date]

DRAWING NO. FP2-21-AB