



- Point of Connection to Existing
- Sidewall Sprinkler Head
- Pendant Sprinkler Head
- Upright Sprinkler Head

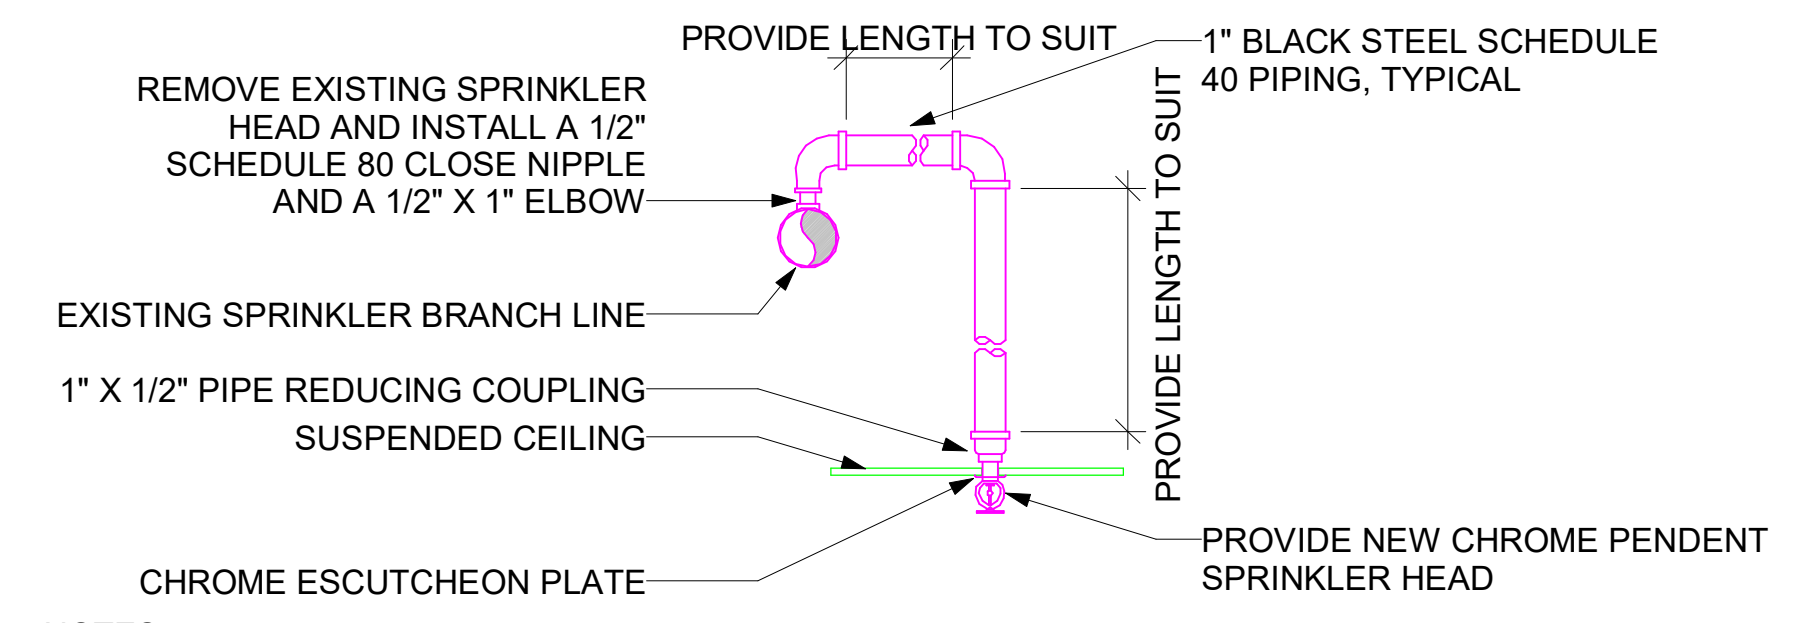

- NOTES:**
- ADJUST SPRINKLER DROPS AS NECESSARY TO CLEAR OBSTRUCTIONS SUCH AS THE CEILING, 1" BAR SUSPENSION SYSTEM, LIGHT FIXTURES, ETC. PROVIDE A PIPE HANGER IF THE HORIZONTAL OFFSET LENGTH EXCEEDS 24 INCHES.
 - THIS SPRINKLER HEAD DROP IS APPLICABLE ONLY WHERE IT IS NOT NECESSARY TO RETAIN AN UPRIGHT SPRINKLER FOR PROTECTION OF COMBUSTIBLE CONSTRUCTION ABOVE THE CEILING.

TYPICAL NEW SPRINKLER HEAD DROP DETAIL
N.T.S.

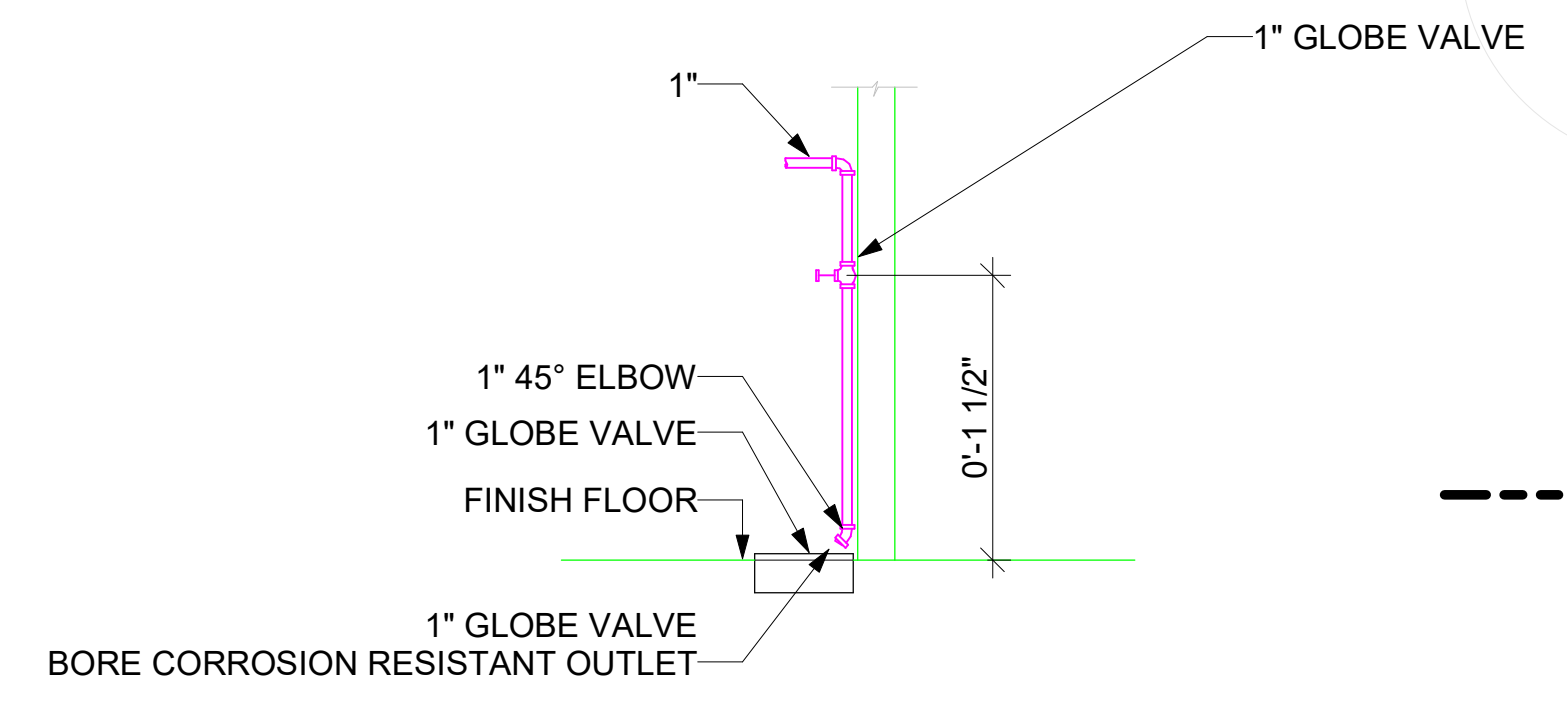

INSPECTOR'S TEST CONNECTION FOR WET PIPE SPRINKLER SYSTEM DETAIL
N.T.S.

AS-BUILT

REVISION	DESCRIPTION	DATE	APPROVED

CONTRACT: C-40218
MEZZANINE BUS EXTENSION AT ULMER PARK BUS DEPOT

FIRE PROTECTION SECOND LEVEL AREA B

FOS
50-01 26TH AVE SUITE 110
WOODSIDE, NY 11377
TEL (718)204-1901/FAX (718)204-1902

NEW YORK CITY TRANSIT AUTHORITY
DEPARTMENT OF CAPITAL PROGRAM MANAGEMENT

DATE: 06/03/2019
DRAWN BY: [Signature]
CHECKED BY: [Signature]
DATE: [Blank]

DATE: 06/03/2019
DRAWING NO. FP2-22-AB

FIRE PROTECTION SECOND LEVEL AREA B
3/8" = 1'-0"