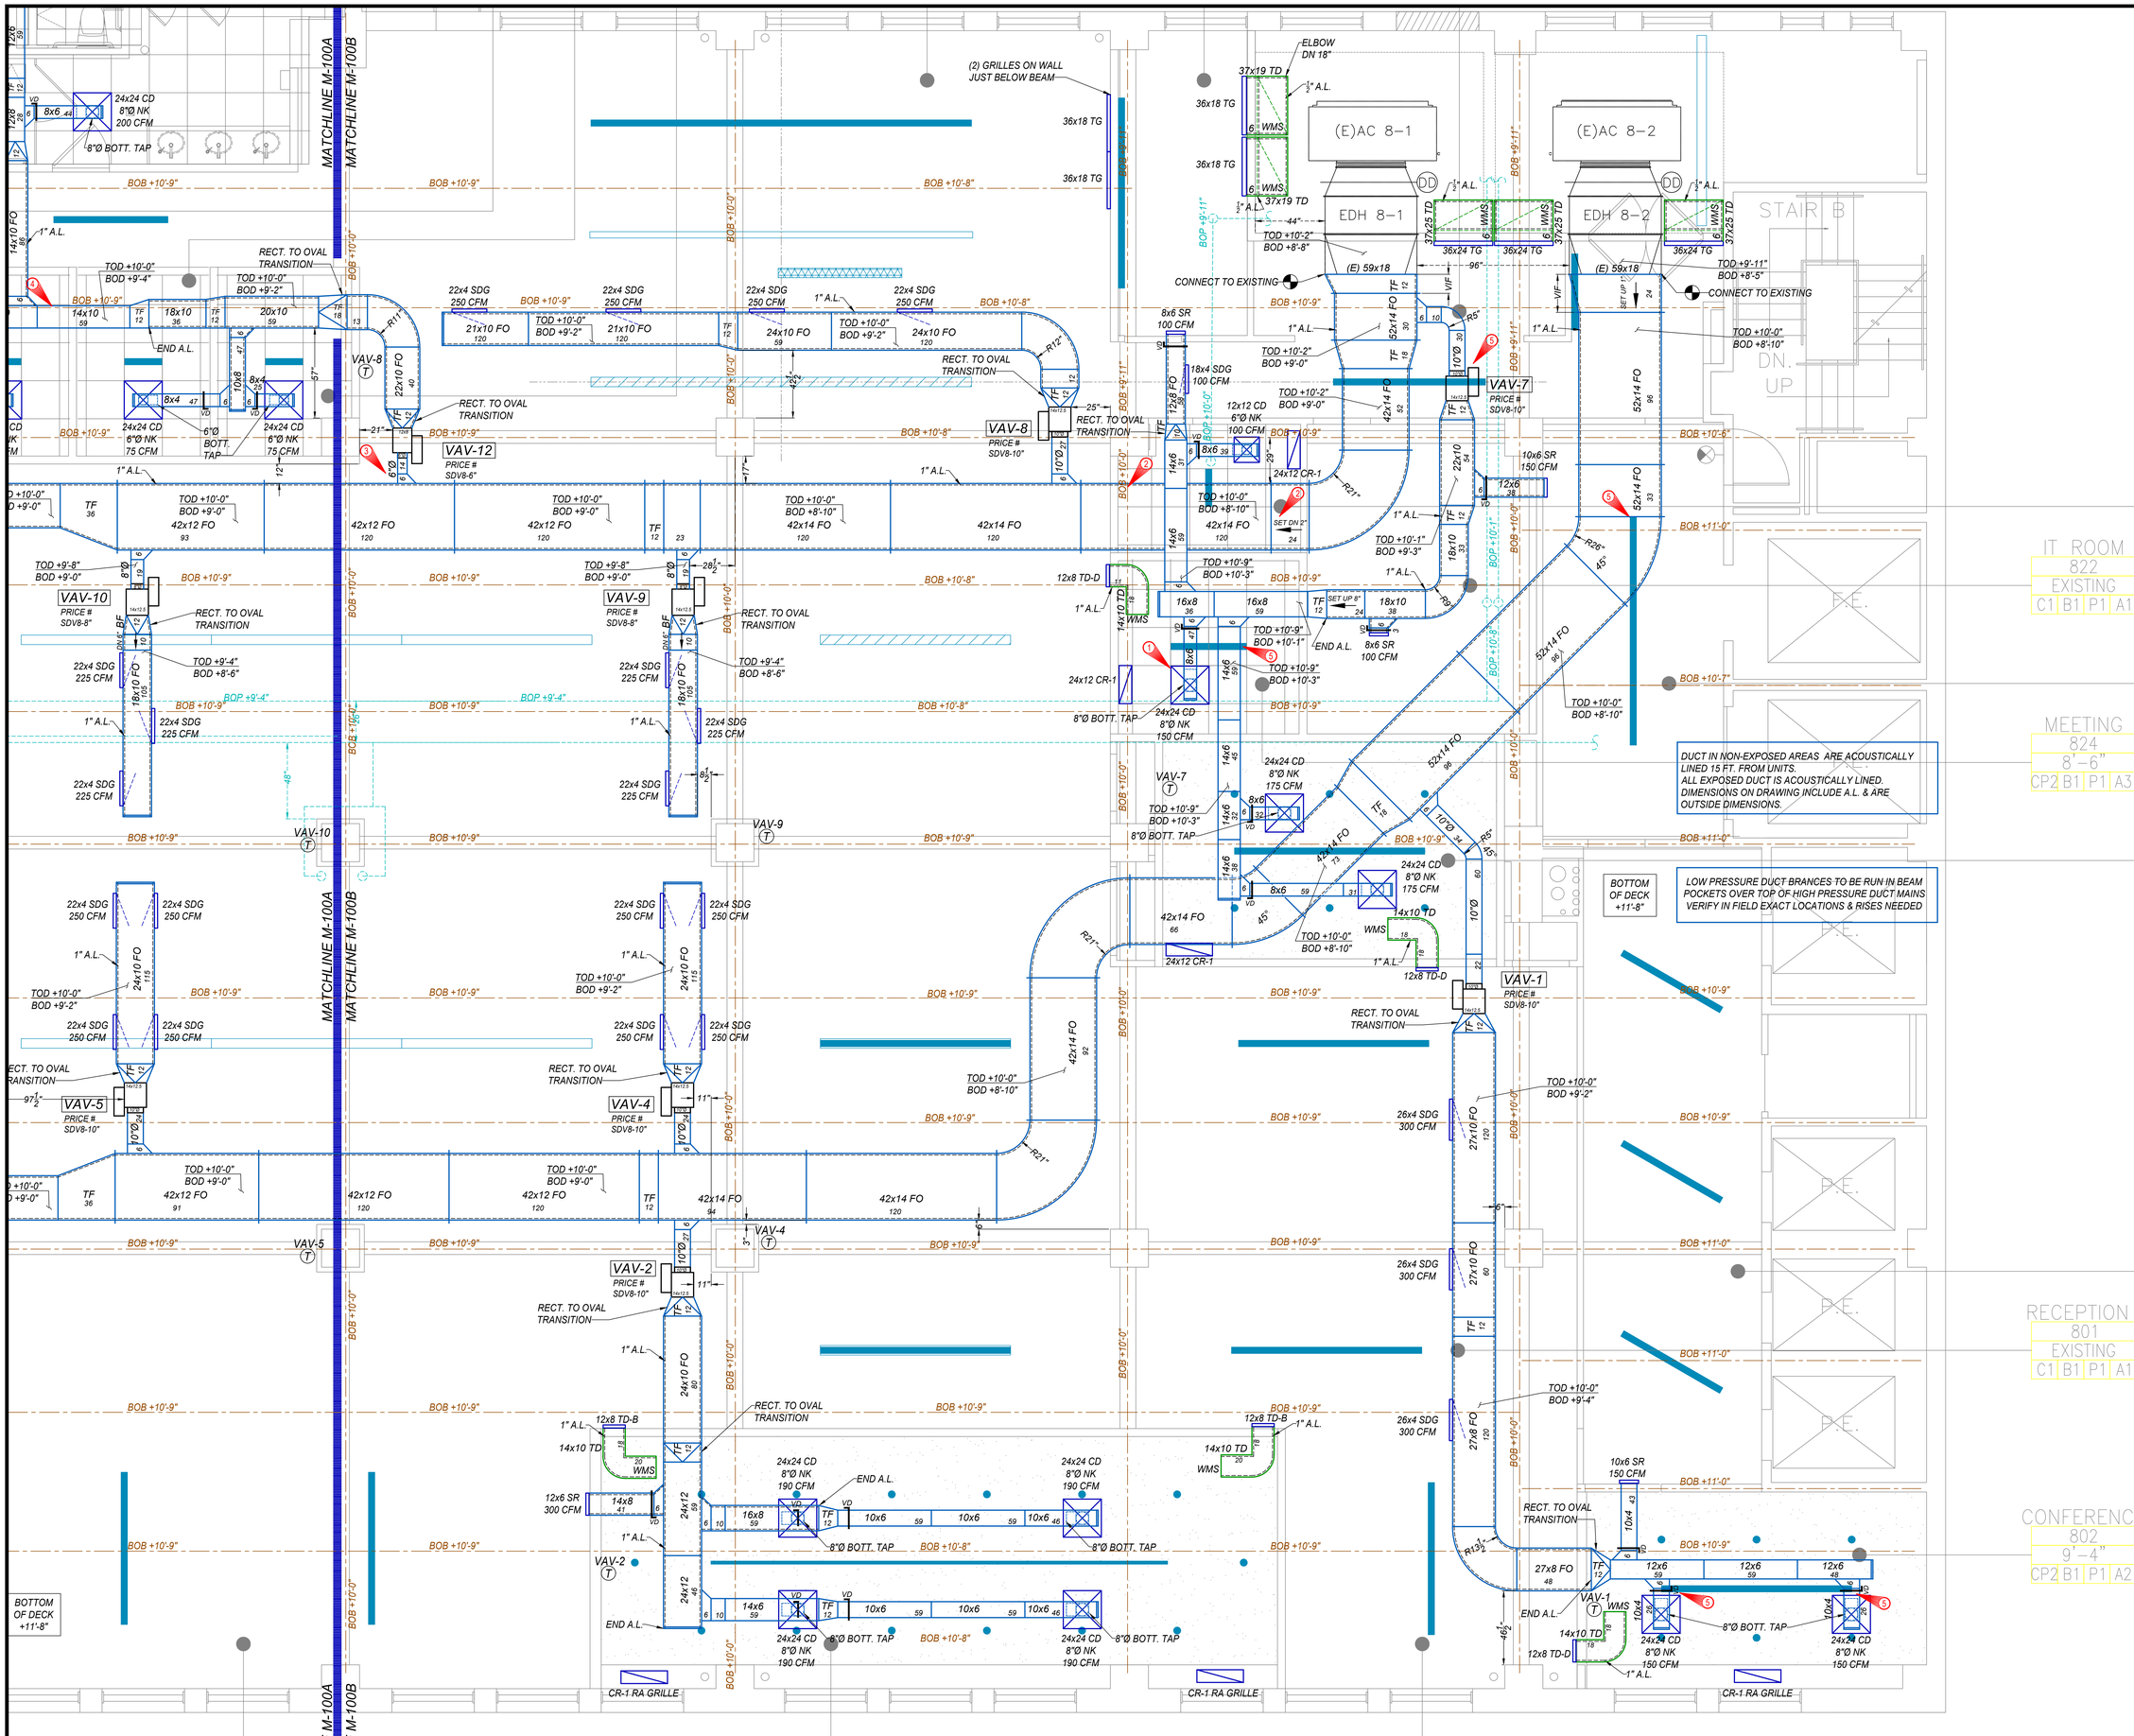

8TH FLOOR - SHEET METAL PLAN

SCALE: 3/8" = 1-0"

FLAG NOTES

1. GRILLE MOVED OFF OF LIGHTING, ENGINEER TO ADVISE IF NEW LOCATION IS OK
2. PLEASE ADVISE IF SET IS NECESSARY AND CAN DUCT BE RUN AT 10'-2" BY NOTCHING 2" OFF OF BEAM.
3. DRAWING CALL FOR A DIFFERENT INTAKE DIAMETER THAN THE EQUIPMENT SUBMITTAL. DRAFTER FOLLOWED THE SUBMITTAL FOR INLET SIZE. PLEASE ADVISE.
4. NOT ON THIS SHEET
5. POSSIBLE CONFLICT W/ LIGHTING

NOTE TO ARCHITECT OR ENGINEER

THIS DRAWING IS A REPRESENTATION OF A PROPOSED LAYOUT. IT IS THE CONTRACTORS RESPONSIBILITY TO VERIFY AND REVIEW PRIOR TO FINAL SUBMISSION. CADDSULTANTS IS NOT RESPONSIBLY FOR DISCREPANCY'S IN THE FIELD. ANY CORRECTIONS TO THE DRAWING IS REQUIRED BY THE CONTRACTOR TO ADVISE CADDSULTANTS BY A RED-LINED SKETCH OR VERBAL DESCRIPTION FOR FINAL SUBMISSION BEFORE FABRICATION & INSTALL. ANY CHANGE FROM ORIGINAL ENGINEERING CONTRACT DRAWING MAY RESULT IN ADDITIONAL COSTS FOR RE-DRAFTING SUCH AS CHANGE ORDERS, DESIGN CHANGES, EQUIPMENT CHANGE OUT OR RELOCATIONS. ADDITIONAL SURVEY MAY BE NECESSARY. CADDSULTANTS IS NOT RESPONSIBLE FOR ANY BACK CHARGES.

NO.	DATE:	DESCRIPTION:
1	06/10/19	FOR APPROVAL

REVISIONS

MECHANICAL CONTRACTOR:

AP MECHANICAL LLC
5 WAREHOUSE LANE
SUITE 160
ELMSFORD, NY 10523

DRAFTING COMPANY:

Professional Drafting Services
Certified / Insured CAD Specialists
Marc W. Hoffman
CADDSULTANTS LLC
167 Allen Road
Rockville Centre NY, 11570
Contact: 646.641.2512
Email: Caddsultant@gmail.com

DRAWING NAME:

8TH FLOOR
SHEET METAL PLAN

PROJECT INFORMATION:

136 MADISON AVENUE
8TH FLOOR
NEW YORK, NY 10016

Drawn by: MLB	Checked by: MH	Page no:
Scale: 3/8"=1'-0"	Date: 06/10/19	Drawing Number
PAGE-36x48		M-100B